

February 17th 2017

#### GARRETT COUNTY COMMUNITY COLLEGE STEM BUILDING 200

#### ADDENDUM #2

TO THE CONTRACT DRAWINGS AND SPECIFICATIONS FOR THE REFERENCED PROJECT, BID SET, DATED FEBRUARY 1ST 2017, AS PREPARED BY GRIMM AND PARKER ARCHITECTS, 11720 BELTSVILLE DRIVE, SUITE 600, CALVERTON, MD 20705.

This Addendum includes changes and clarifications to the Contract Documents. This information includes the following:

### **SPECIFICATIONS:**

ITEM NO. 1: SECTION 08 80 00 – GLAZING

**ADD** Add to paragraph 1.3 – Submittals:

- "I. Submittals for Glass Canopies:
  - 1. Provide product data for all proposed components, materials, products, and accessories.
    - a. For each type glass, provide maximum allowable stress in both horizontal and vertical directions.
    - b. Provide product data for all fittings and hardware.
  - 2. Shop drawings:
    - a. Plans, elevations, and sections illustrating shape, configuration, and dimensions.
    - b. Illustrate method of assembly, installation, and glazing.
    - c. Provide details for support framing, reinforcement, connections, joints, anchors, and other fabrication and installation conditions.
    - d. Indicate required tolerances and coordination with adjacent elements and work of other trades.
  - 3. Calculations: Show compliance with performance criteria and applicable loads with stamp of Licensed Professional Engineer registered in the State of Maryland."

### **ADD** Add paragraph 1.9 as follows:

#### "1.9 DESIGN AND PERFORMANCE CRITERIA FOR GLASS CANOPY

- A. Design the size and quantity of components, and install glass canopy in accordance with ASTM E1300 to withstand these loads without breakage, loss, failure of seals, product deterioration, and other defects.
  - 1. Dead and live loads: Determined by ASCE 7-10 and calculated in accordance with applicable codes.
  - Seismic loads: System shall be designed and installed to comply with applicable seismic requirements for Project location and Seismic Zone 1 defined by of ICC/IBC.
  - 3. Movement and deflection of structural support framing.
  - 4. Effects of applicable wind load acting inward and outward normal to plane of canopy in accordance with ASTM E330.
  - 5. Thermal loads and movement:
    - a. Ambient temperature range: 120 degrees F.
    - b. Material surfaces range: 180 degrees F.
- B. Provide and install exterior gaskets, sealants, and other glazing accessories to resist water penetration. There shall be no penetration at 15 pounds/square foot test pressure and 5 gallons/hour/square foot water rate tested in accordance ASTM E331.

#### ITEM NO. 2: SECTION 09 68 13 – TILE CARPETING

**DELETE** Delete from paragraph 2.2A – Materials:

Delete the following line:

"4. CPT4: Mannington Commercial, Recoarse II 38 oz, Color 8413 Traverse Tan."

#### ITEM NO. 3: SECTION 23 09 00 – INSTRUMENTATION AND CONTROL FOR HVAC

**REVISE** Revise paragraph 2.18-2-C-1.a.1:

Revise paragraph to read:

"1) Provide 46" Touchscreen (UL approved, powered by 110 Volt wall plug) with native resolution of 1360 x 768 60 HZ (minimum) and all necessary cables"

Recess mount screen so when mounted the screen won't project more than 4" from the wall in order to meet ADA requirements.

#### ITEM NO. 4: SECTION 28 13 00 – ACCESS CONTROL

**REVISE** Revise paragraph 2.4H:

Revise paragraph to read:

- "H. Materials and Programming to be obtained by:
  - 1. Christina Corey, Intertech CI, 1501 Preble Avenue Pittsburgh PA 15233.

Ccorey@intertechci.com 412-980-1229

2. ARK Systems"

Addendum 2 Page 2 of 6

Garrett County Community College STEM Building 200 Addendum #2

ITEM NO. 5: SECTION 28 13 00 – ACCESS CONTROL

**DELETE** Section 2.1 to be deleted in its entirety.

ITEM NO. 6: SECTION 28 13 00 – ACCESS CONTROL

**DELETE** Section 2.2 to be deleted in its entirety.

#### **DRAWING ITEMS:**

ITEM NO. 7: CIVIL SHEET C2.0

**REVISE** Width of concrete sidewalk has been increased to 6'-0". (see attached drawing)

ITEM NO. 8: ARCHITECTURAL SHEET A-3.2

**REVISE** Flooring material at south entry Vestibule 200A to be PT1. Owner will provide removable roll-out mats

on top of porcelain tile. CPT4 has been removed from the project. (see attached drawing)

ITEM NO. 9: ARCHITECTURAL SHEET A-5.2

**ADD** Provide "No Smoking" decal at entry doors. (see attached drawing)

ITEM NO. 10: ARCHITECTURAL SHEET A-6.1

**REVISE** Cabinet changes have been made to drawings 5 and 7.

**DELETE** A note was deleted from drawing 22. (see attached drawing)

ITEM NO. 11: ARCHITECTURAL SHEET A-9.2

**REVISE** Cabinet changes have been made in Physics/Earth Science #226. The size of the sink in the southwest

corner of Physics/Earth Science #226 has been revised.

ADD Missing size for the sink in northeast corner of Physics/Earth Science #226 has been noted. (see attached

drawing)

ITEM NO. 12: ELECTRICAL SHEET E-0.2 – LIGHTING FIXTURE SCHEDULE

**ADD** For types 'G1', 'G1E', 'G2', and 'G3' under the COMMENTS column add: "**PROVIDE UNIT** 

PRICING."

ITEM NO. 13: PLUMBING SHEET P-0.1 – FOUNDATION - PLUMBING

**DELETE** Foundation drain around addition and existing foundation drain around existing building in its entirety.

Delete associated notes.

<u>ITEM NO. 14:</u> <u>PLUMBING SHEET P-2.1 – FIRST FLOOR - PLUMBING</u>

**ADD** 3" SW piping to OHDs that have been added to either side of units in penthouse. SW piping shall

connect to 3" SW piping in ceiling space.

**REVISE** Location of P5 and associated piping in Engineering/Robotics 236. Shift piping and fixture project east

4'-0".

Addendum 2 Page 3 of 6

ADD ½" CW piping to glass ware dishwasher (DW) in Biology/Prep Storage 229B for connection to drain

cooling kit.

ITEM NO. 15: PLUMBING SHEET P-3.1 – MECHANICAL ROOM AND PENTHOUSE FLOOR – PART PLANS

**ADD** Total of three (3) additional 3" open hub drains (OHDs) in penthouse for condensate collection. Add two

(2) additional drain connections and condensate traps to opposite side of AHUs so that each unit drains on each side (6 total OHDs, 12 condensate connections and traps, 2 on each side of unit). Add drawing

note #1 to point to condensate traps that have been added.

**ADD** Condensate drain and trap on opposite side (right side) of AHU-1 in mechanical room and drain to 4"

FD-A.

**REVISE** Pipe condensate from Split A/C Unit in IT 220A adjacent to mechanical room to floor drain to north.

**REVISE** Shift location of 4" FD-A in mechanical room between boiler #1 & #2 project north 1'-6" so that it is off

of equipment pad.

ITEM NO. 16: PLUMBING SHEET P-6.2 – LP GAS & VACUUM SYSTEM RISER DIAGRAMS

**REVISE** Note referring to underground vacuum piping. Change note to read "Vacuum gas piping in 3" PVC

conduit below slab. Piping shall be soft copper tubing, type 'L' and no joints (typ)."

ITEM NO. 17: MECHANICAL SHEET M-7.4 – MECHANICAL DETAILS

**REVISE** Piping diagram has been revised. Refer to sketch M-2.1 for additional information.

**REVISE** Equipment and design notes have been revised. Refer to sketch M-2.2 for additional information.

**REVISE** Part plan has been revised to include the sidewalk leading to the entry of building 300. Refer to sketch

M-2.3 for additional information.

#### **QUESTIONS:**

**ITEM NO. 18:** 

**QUESTION** On drawing M-2.1, note 7 says 2" polypropylene vent to chemical storage cabinet. Should this be

referencing the fume hoods? Please verify exactly what this note should reference and the type of

material.

**ANSWER** No it's for the storage cabinets in the chemical storage room. Polypropylene is the material of pipe

available by plastic pipe manufacturers, typically for acid waste systems.

ITEM NO. 19:

**QUESTION** 084313-1.5-C.1 & 084413-1.6-C.1 – Is it required to have the storefront / curtain wall shop drawings

"prepared by the manufacturer"? Typically, we self-perform the shop drawings and submit to a

Maryland licensed PE for review, sign and seal.

The problems that I see occurring are:

a. Some manufacturers will not provide in house shop drawing services for a project this size.

b. Having the shop drawings prepared by the manufacturer extends submittal lead-times and can significantly increase the cost.

Addendum 2 Page 4 of 6

ANSWER Shop drawings don't have to be prepared by the storefront / curtainwall manufacturer provided they are

drawn to scale, drawn in CAD, are complete with all details and conditions included, and approved by

the manufacturer.

ITEM NO. 20:

**QUESTION** 088000-2.3-D.4 – Glass type 'G-2' is called to have a colored interlayer. Can you please specify the

color to be used? In past experiences, different colors incur different costs.

**ANSWER** The interlayer is to be translucent white as noted in the 'Glass Type Key' on sheets A-3.4 & A-3.5.

**ITEM NO. 21:** 

**QUESTION** ARK Systems is a Lenel authorized VAR and a provider of access control solutions to Garrett College.

Please add ARK Systems as an approved vendor under Section 28 13 00 – 2.4H.

**ANSWER** ARK Systems will be added as an equal.

<u>ITEM NO. 22:</u>

**QUESTION** "Application software shall be General Electric Secure Perfect Version 6 or higher". GE Security was

purchased by Lenel. The manufacturer states that the Secure Perfect software package is obsolete and

cannot be expanded. Please confirm the software package currently in use.

Please specify if the existing package is capable of supporting the additional readers and clients.

**ANSWER** Software package currently in use is Lenel OnGuard. Sections 2.1 and 2.2 in spec section 28 13 00 will

be deleted.

The existing package is capable of supporting the additional readers and clients.

ITEM NO. 23:

**QUESTION** I was wondering if there is a specification for the glass canopy. I could not locate it in either division 8 or

10.

**ANSWER** There is not a separate specification section for the glass canopy. Information about the glass for the

glass canopy is located in section 088000-2.2-E. Information about the glass supporting fittings is located in section 088000-2.3-E. Information about the structural steel for the glass canopy is located in section 051213. See item number 1 of this addendum for additional information regarding the glass canopy.

ITEM NO. 24:

**QUESTION** What is the mounting height for the short throw projectors?

**ANSWER** The short throw projectors are to be mounted 8'-8" A.F.F. – Refer to manufacturer's installation

instructions for additional information.

<u>ITEM NO. 25:</u>

**QUESTION** 084313-2.3-B -- What stile of aluminum door is required? (narrow, medium, wide)

**ANSWER** Wide stiles are to be provided.

Addendum 2 Page 5 of 6

Garrett County Community College STEM Building 200 Addendum #2

ITEM NO. 26:

**QUESTION** 084313-1.5-D – States to provide data based on the impact of the "frame mounted sunshades"; however I

do not see any sunshades present on this project. Please confirm.

**ANSWER** There are no sunshades in this project.

**ITEM NO. 27:** 

**QUESTION** WALL SECTION A11 / A4.2 – Depicts a curtain wall mid-span anchor tied off to the steel 'I' beam

above the gyp board ceiling. With this anchor being oriented towards the top of the elevation, it will not carry the maximum windload. Can we mid-span anchor at the lower tube steel (in addition to, or in lieu

of) the top anchor? (It would be hidden to the exterior by the 'G2' glazing.)

**ANSWER** Yes. The condition for the mid-span anchor at the lower tube steel is shown in structural detail F/S-5.1.

**ITEM NO. 28:** 

**QUESTION** Drawing S1.1 shows "remove existing toping slab coat to original slab depth. Level over with Ardex

SD-P and Ardex Feather Finish)

- What is the depth of the topping slab to be removed?

**ANSWER** It is unknown if there even is a topping slab. The contractor shall remove whatever was used to build up

this area.

ITEM NO. 29:


**QUESTION** What thickness will the Ardex be installed?


**ANSWER** This information was provided in Addendum #1.


END OF ADDENDUM NUMBER 2 NARRATIVE


\*\*\*\*


Addendum 2 Page 6 of 6

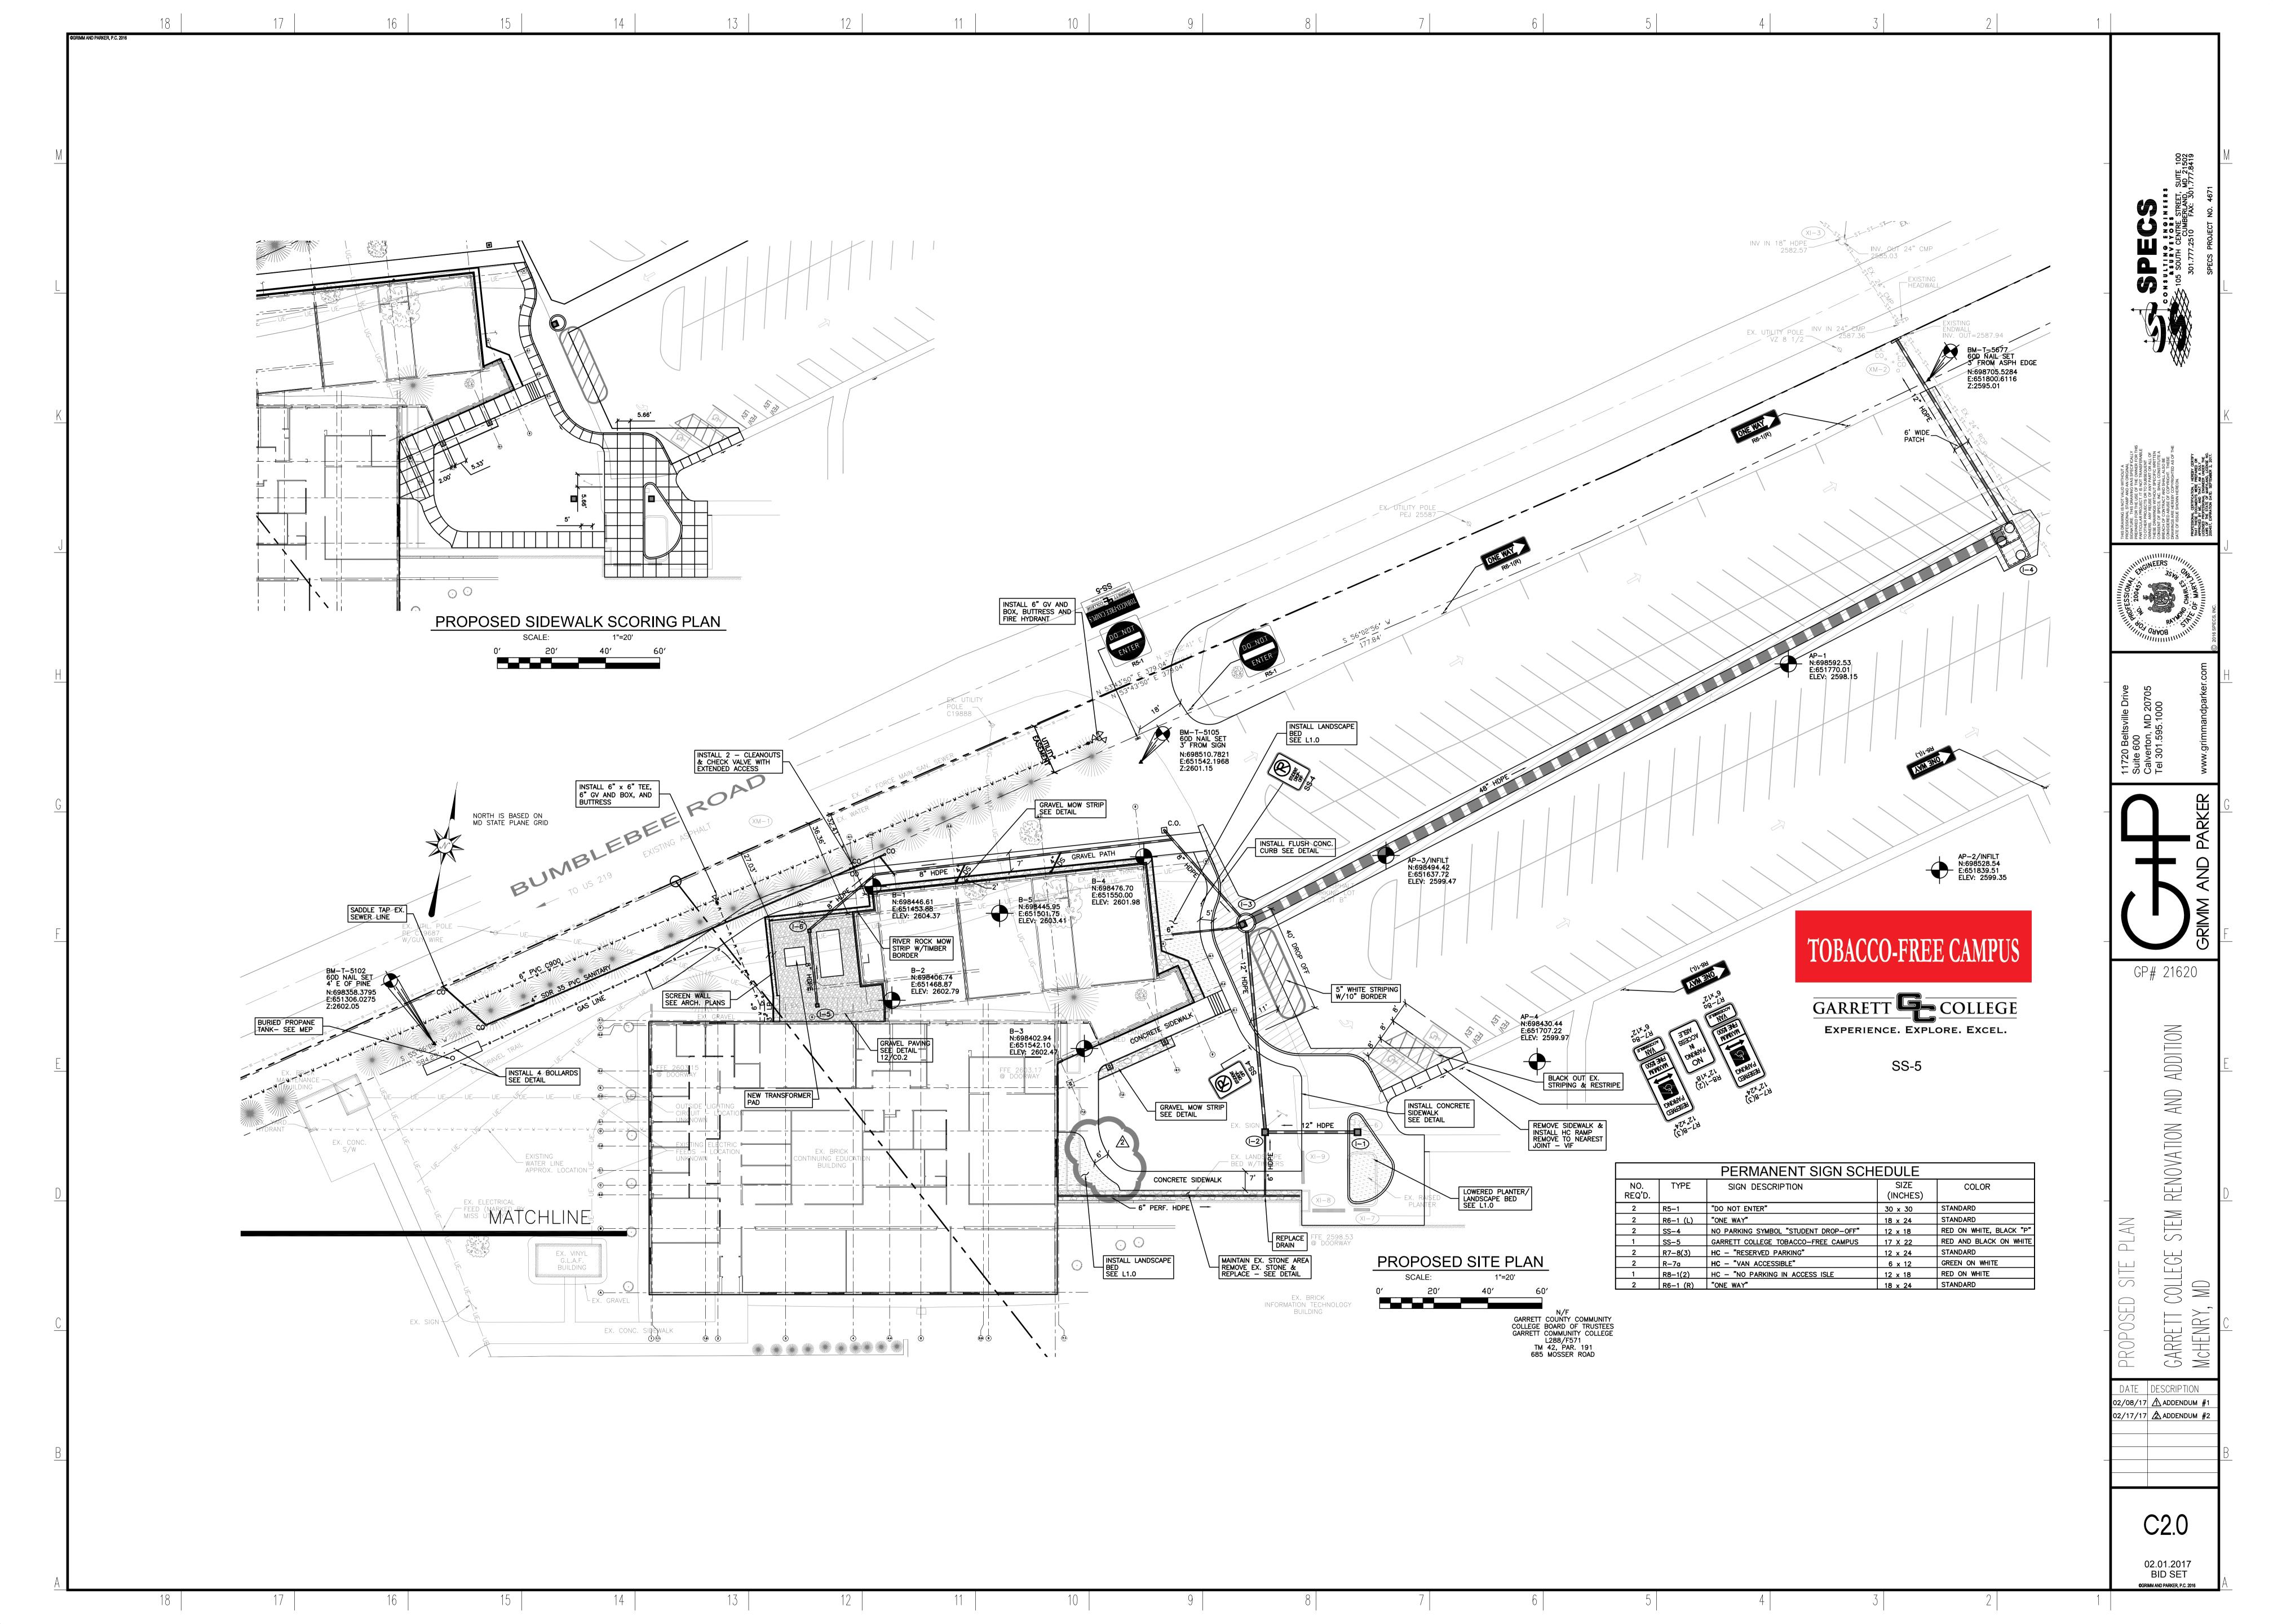


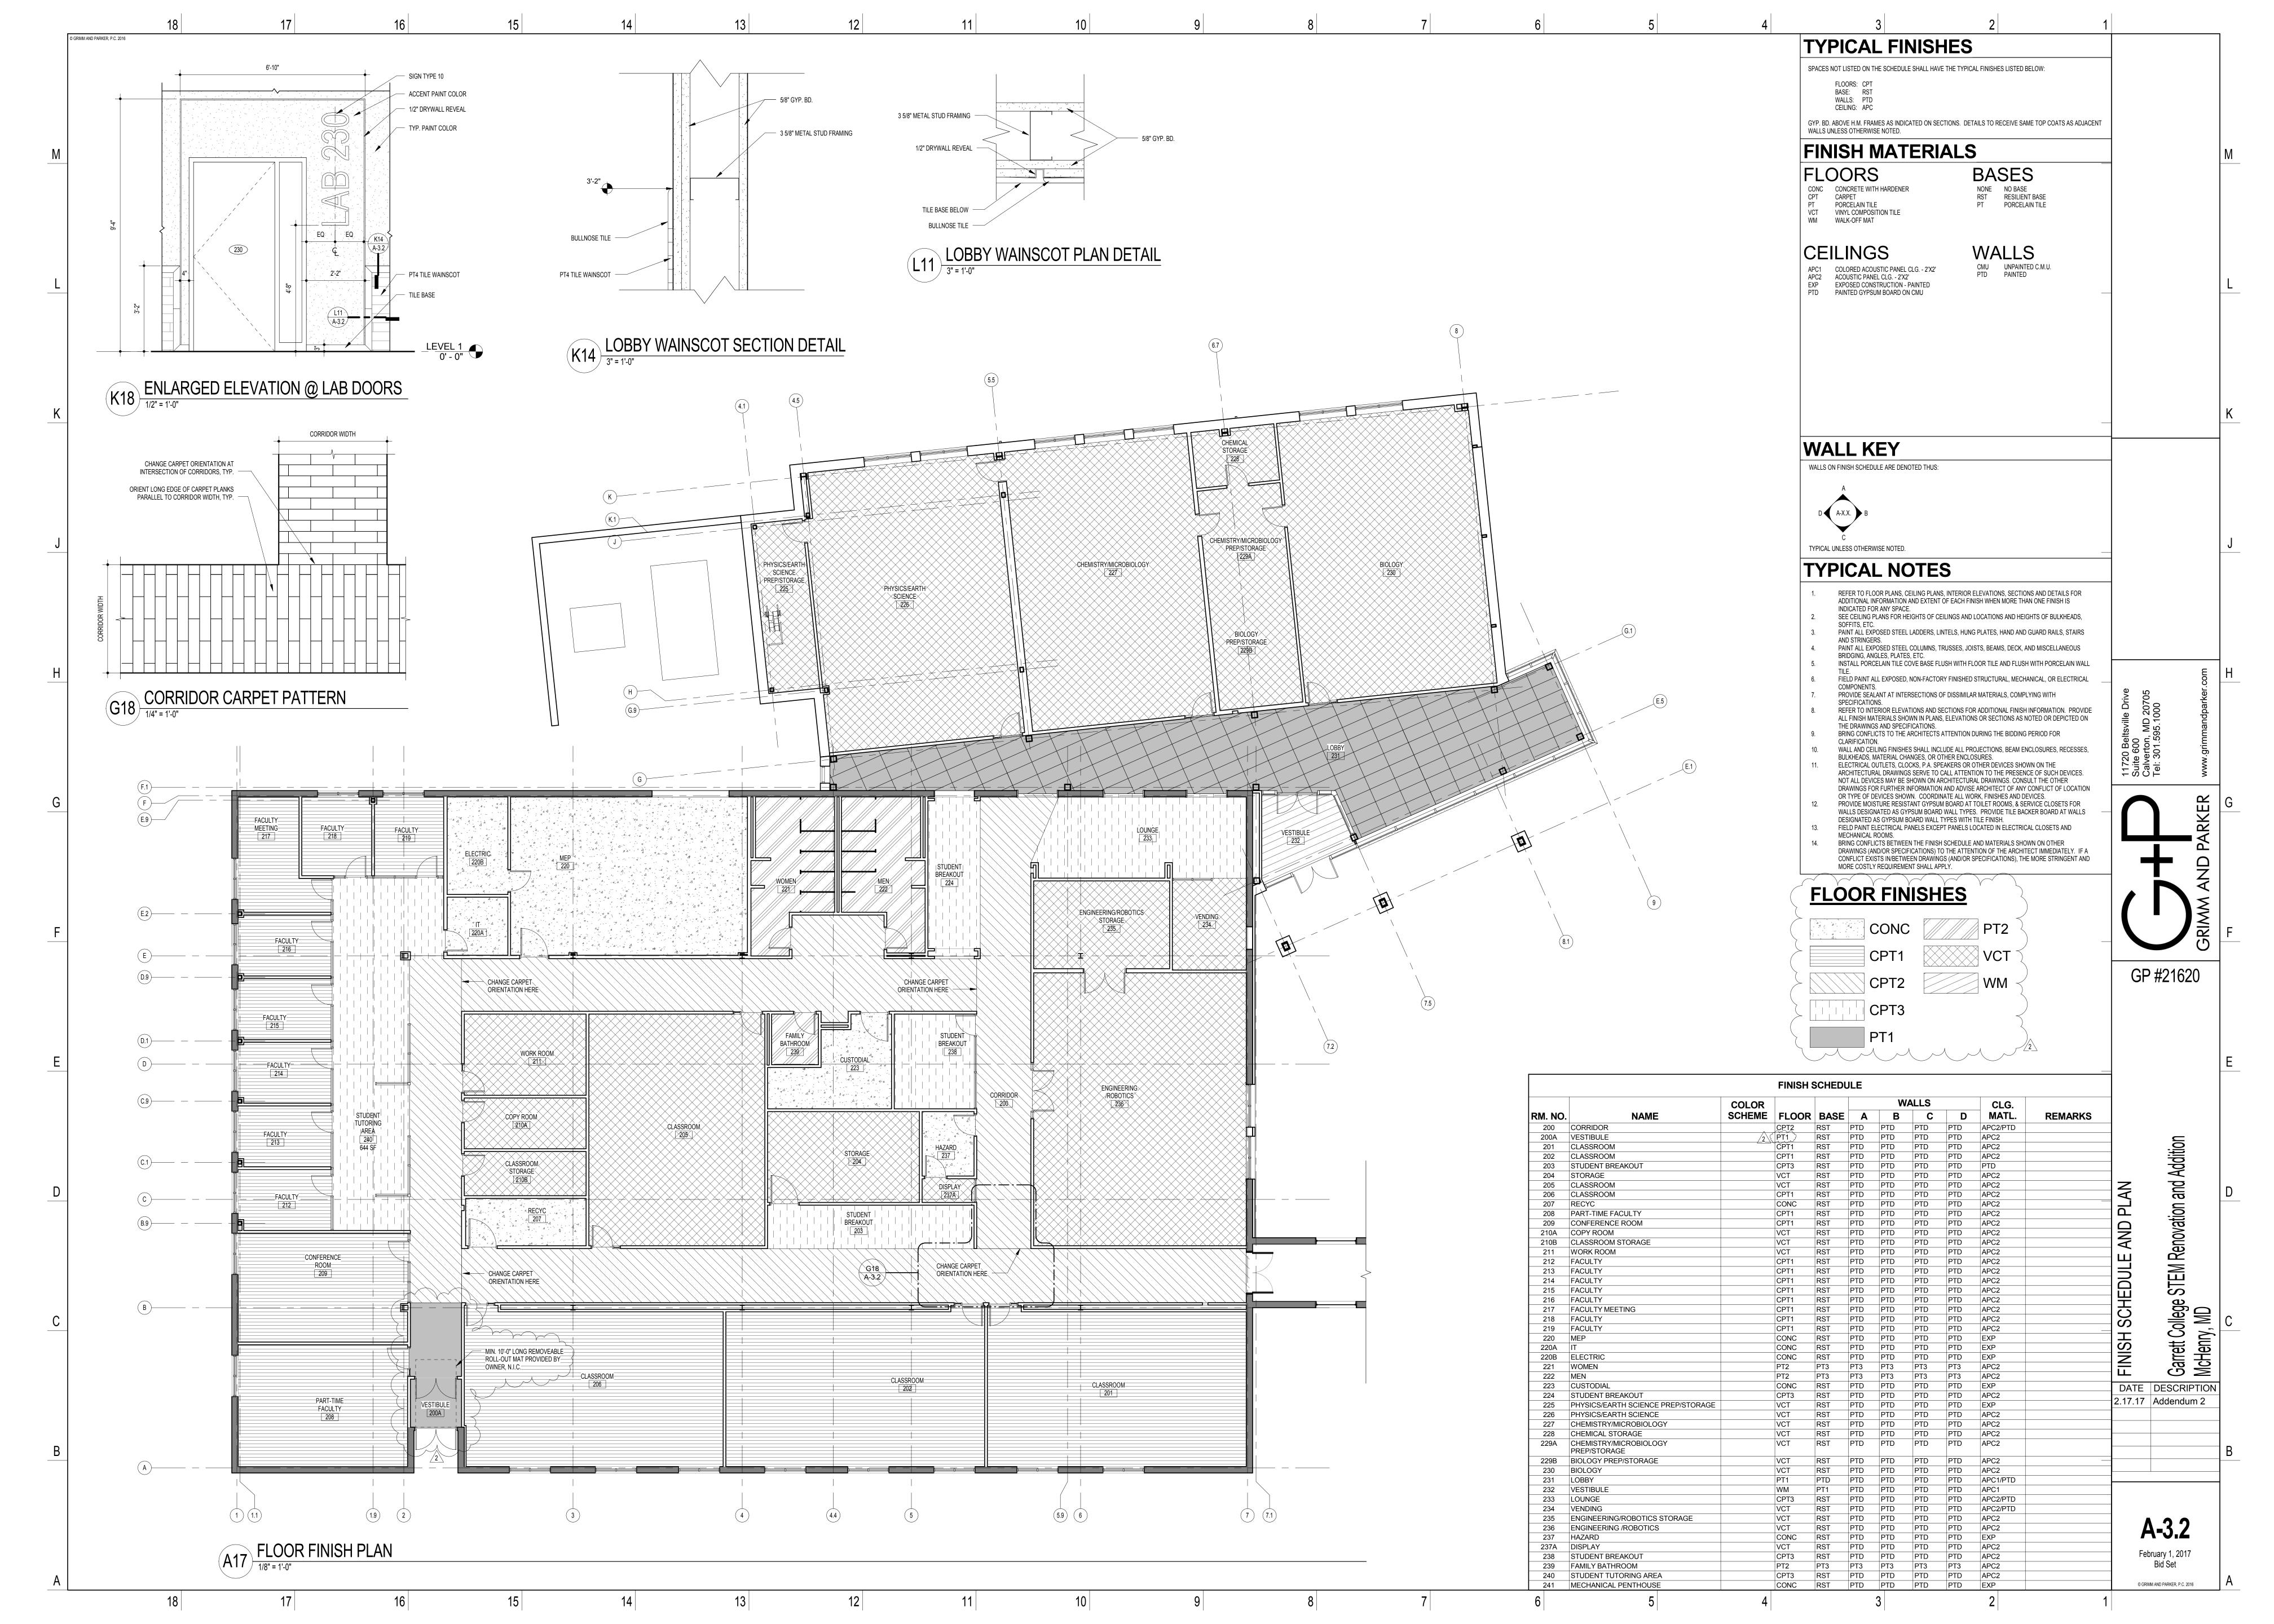

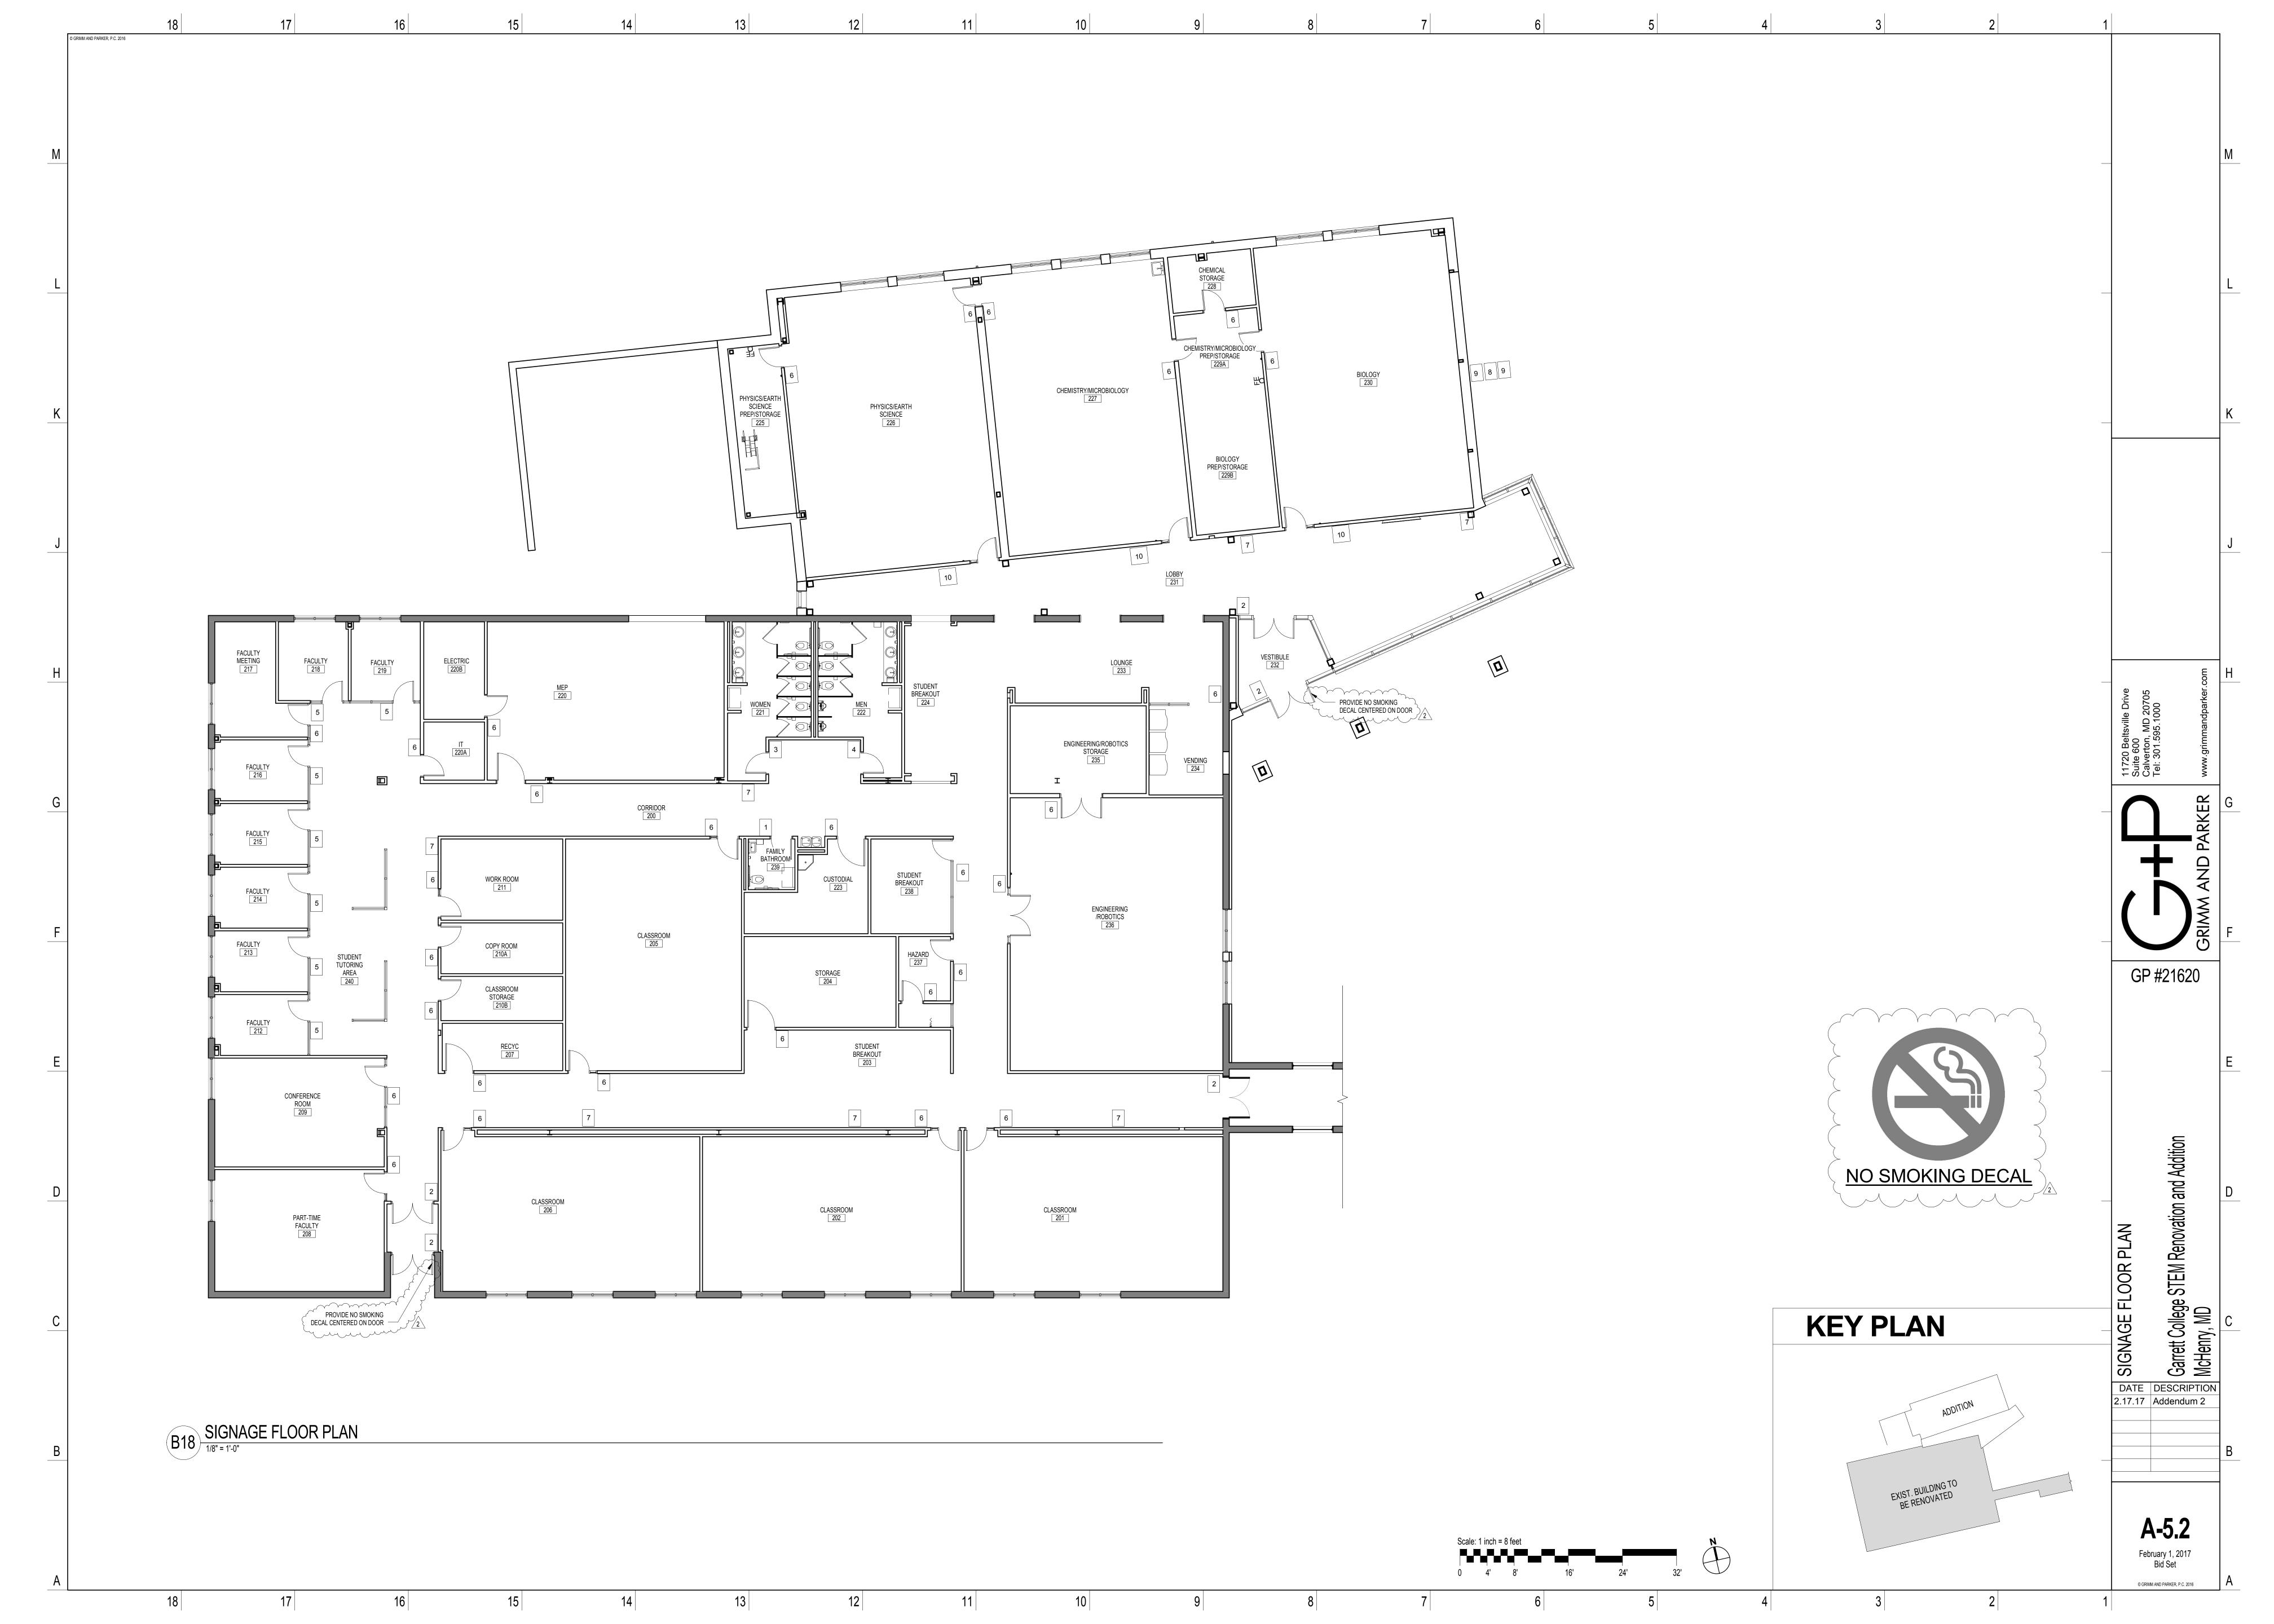

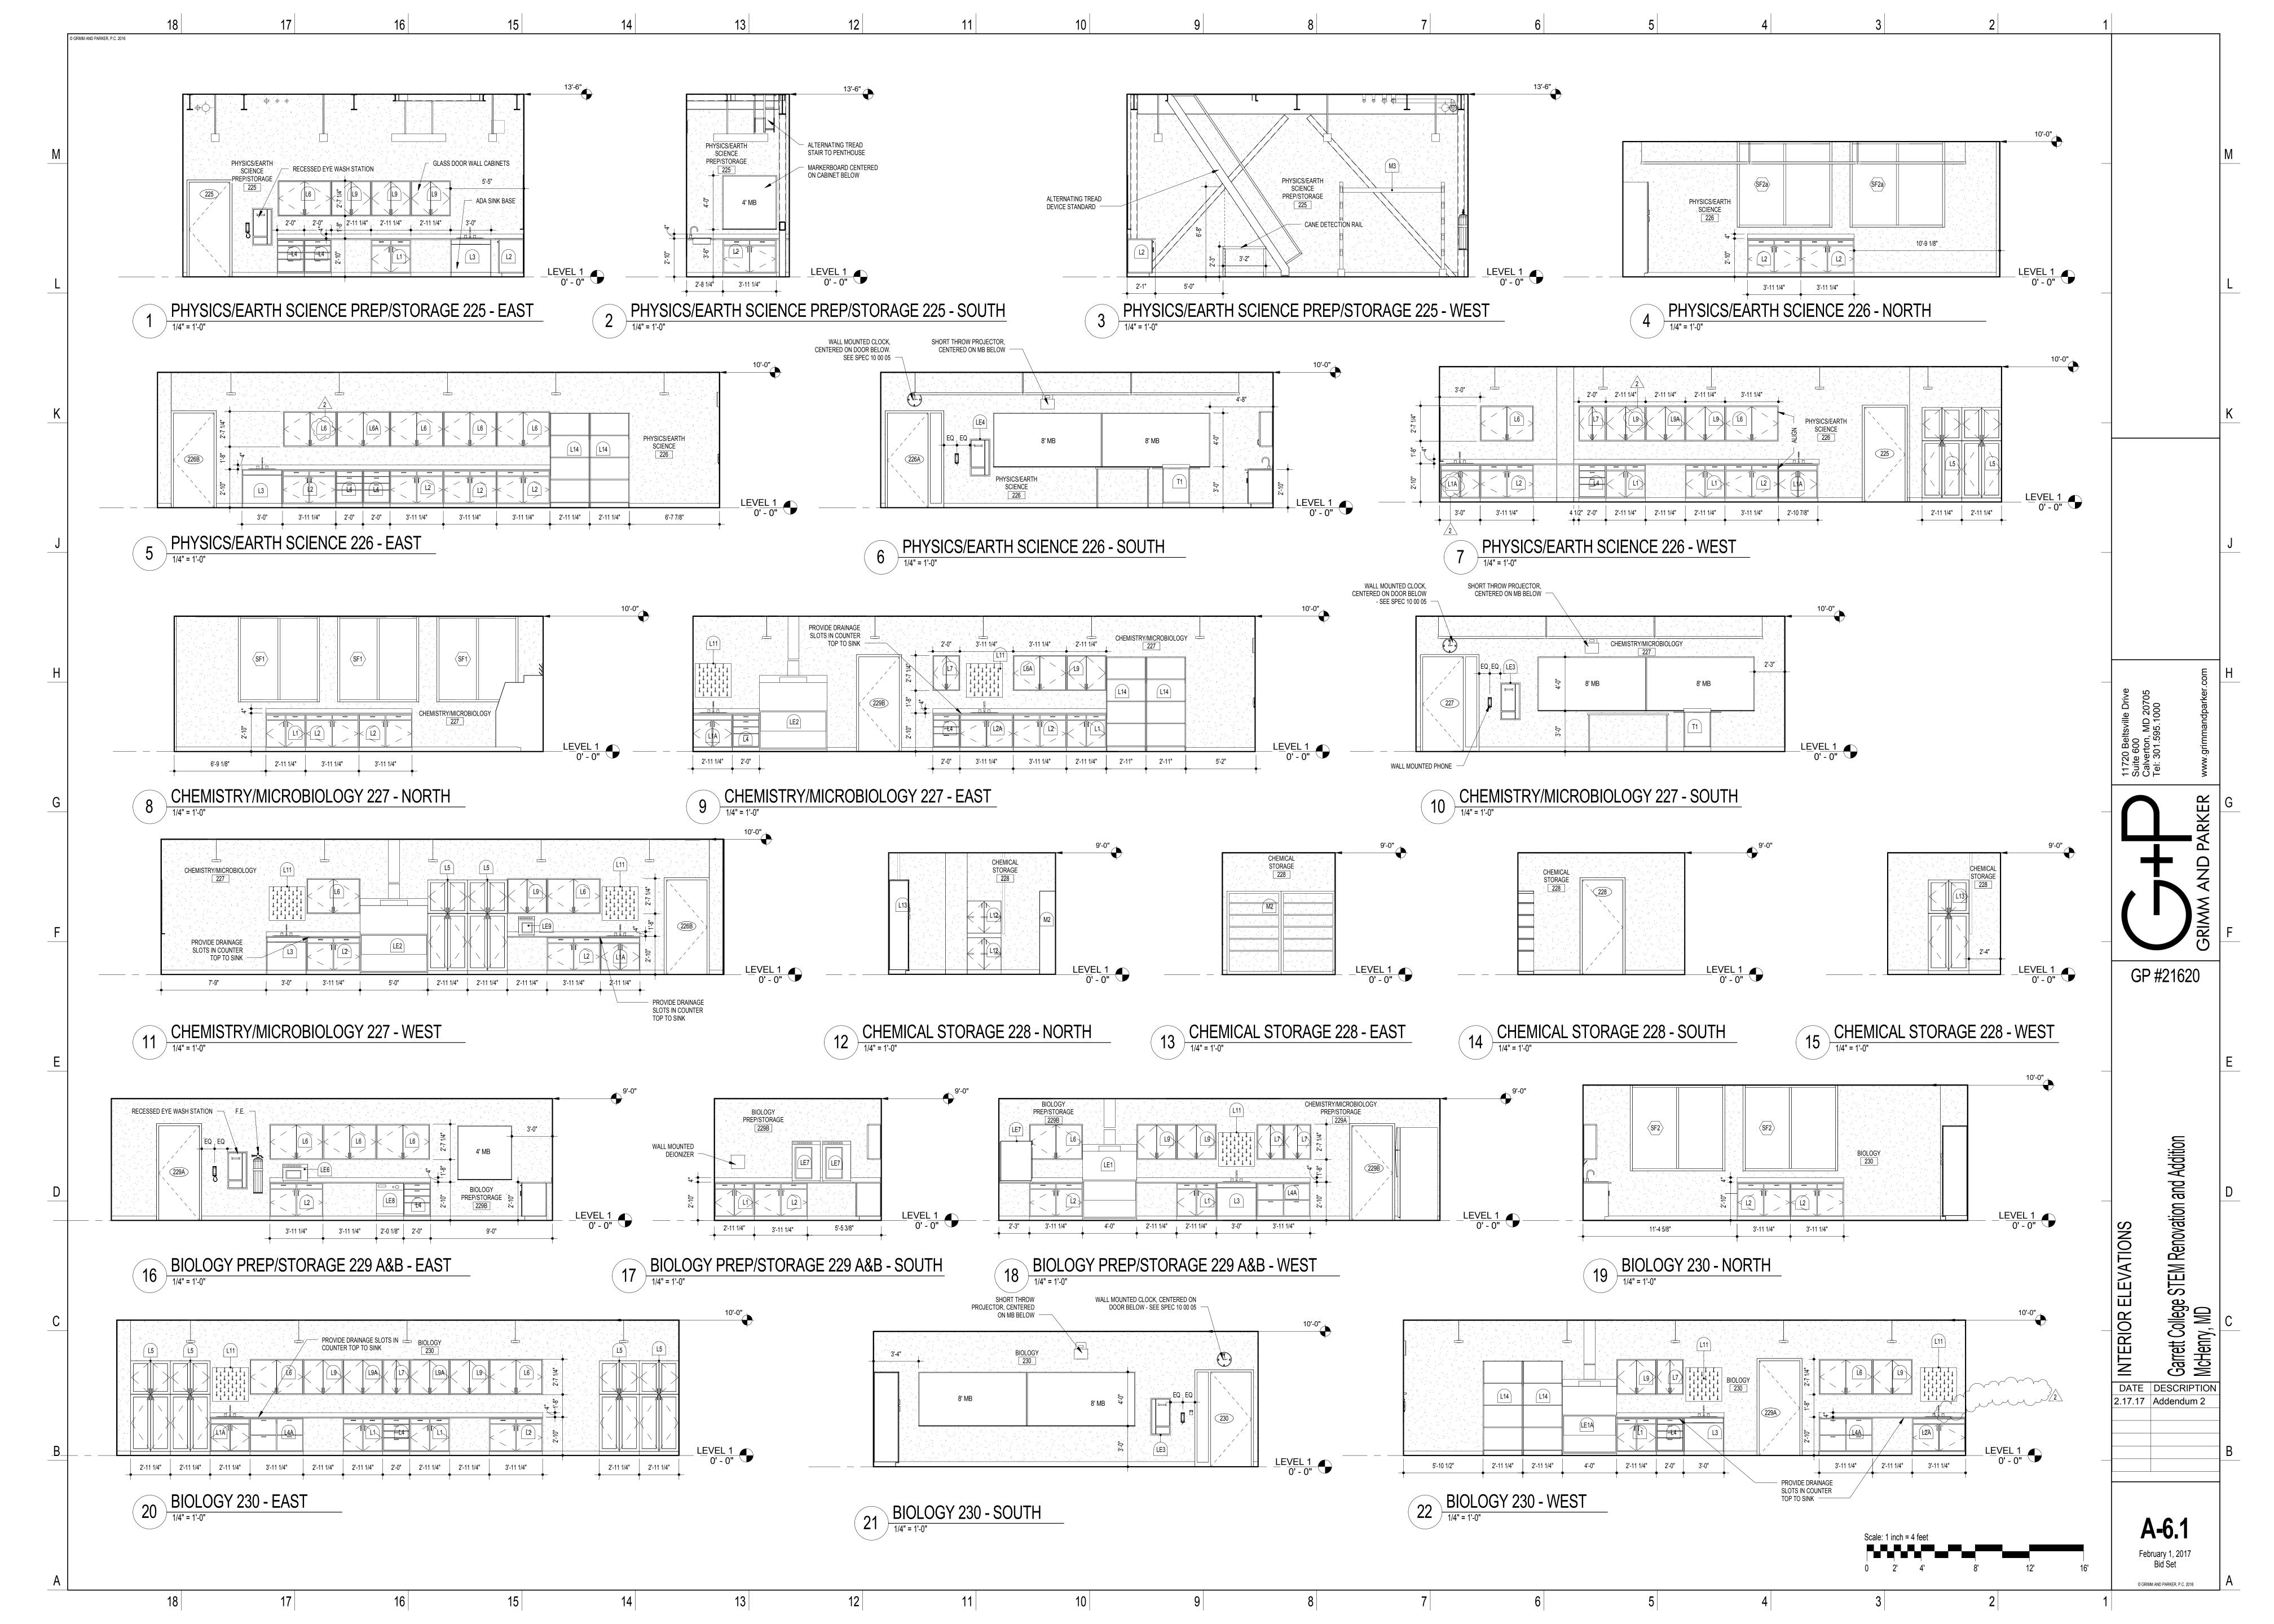

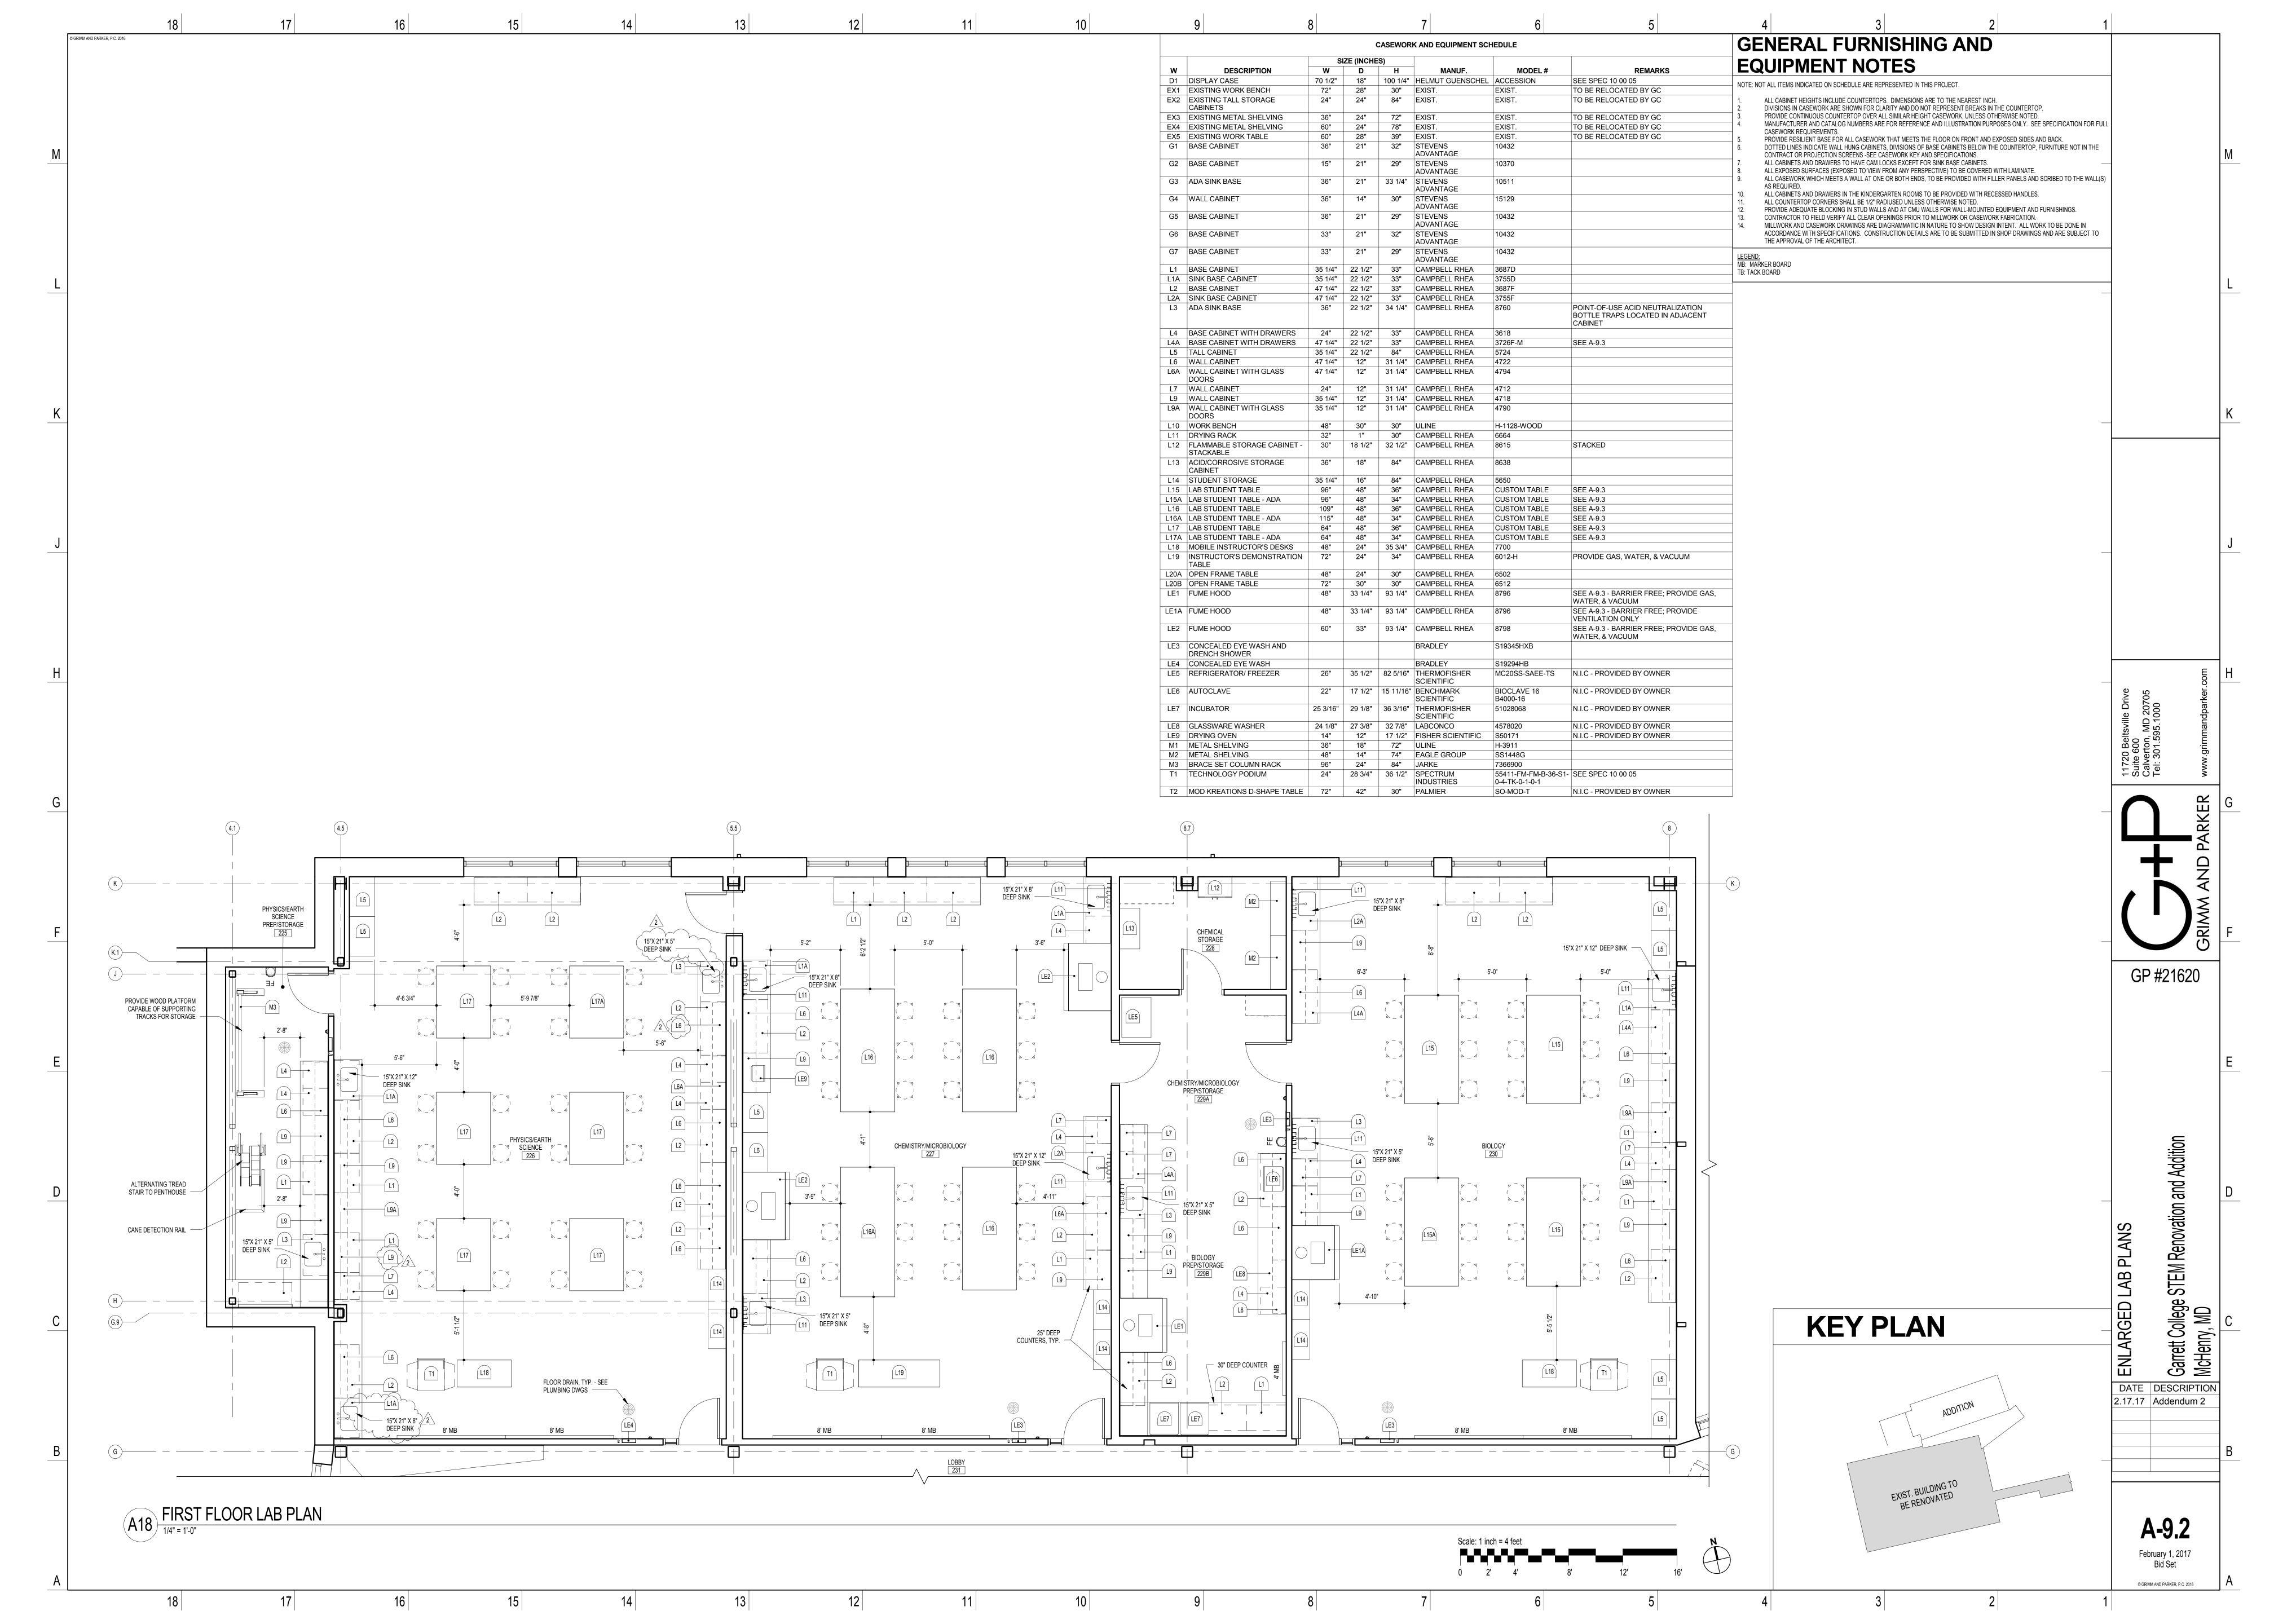

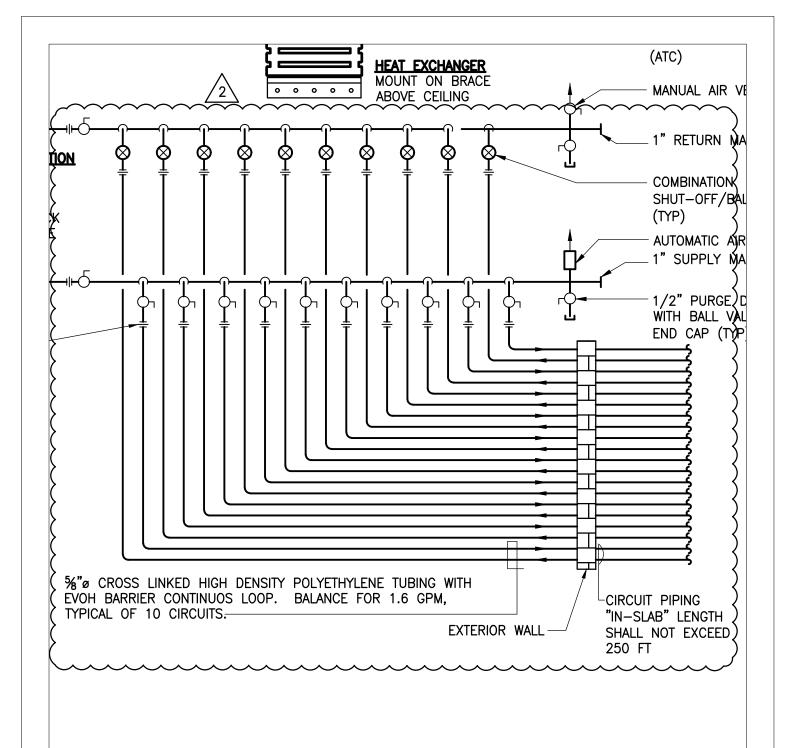

# HYDRONIC SNOW MELT PIPING DETAIL

SCALE: NOT TO SCALE

Garrett College STEM Addition & Renovation REF - M-7.4 - MECHANICAL DETAILS

SCALE: NONE

DATE | ADD | 02/17/17 | M-2.1

GRIMM AND PARKER

11720 Beltsville Drive Suite 600 Calverton, MD 20705

www.grimmandparker.com

# DESIGN NOTES:

- HYDRONIC SNOW MELTING SLAB SHALL CONSIST OF RAMPS AND LANDINGS AS OUTLINED/SHOWN. REFER TO ARCHITECTURAL DRAWINGS AND DETAILS FOR ADDITIONAL INFORMATION ON RAMP AND LANDING CONSTRUCTION. THE MANUFACTURER SHALL CONFIRM ALL EQUIPMENT CAPACITY BASED ON AREA SERVED.
- 2. DESIGN AND INSTALL CIRCUIT PIPING PER MANUFACTURERS (VIEGA) RECOMMENDATIONS.
- **DESIGN PARAMETERS:**

VIEGA SYSTEM: DESIGN LEVEL TYPE II TOTAL SNOW MELT AREA: APROX. 1,460 FT2 UNIT HEAT LOAD: 200 BTUH/FT2 WATER TEMPERATURE: 130 'F AVG. SPACING: 9 IN.



292,000 BTUH HEAT TRANSFER

PROPYLENE GLYCOL (40%) - COLD SIDE

15.8 GPM FLOW RATE

0.94 BTU/LB \*F - SPECIFIC HEAT

1.03 SPECIFIC GRAVITY

0.28 BTU/HR FT 'F - THERMAL

CONDUCTIVITY

1.26 CPS @ AVG. TEMPERATURE -VISCOSITY

90°F INLET WATER TEMPERATURE

130°F OUTLET WATER TEMPERATURE

5 FT. OF HEAD MAX. WPD

15 CHANNELS, 0.49 FT/SEC

HEATING WATER - HOT SIDE

29.6 GPM FLOW RATE

1.00 BTU/LB \*F - SPECIFIC HEAT

1.00 SPECIFIC GRAVITY

0.38 BTU/HR FT 'F - THERMAL

CONDUCTIVITY

0.93 CP @ AVG. TEMPERATURE -

**VISCOSITY** 

140°F INLET WATER TEMPERATURE

120°F OUTLET WATER TEMPERATURE

10.3 FT. OF HEAD MAX. WPD

14 CHANNELS, 0.98 FT/SEC

MANUFACTURER: VIEGA HEAT EXCHANGER

### INJECTION PUMP

17 GPM, 30' HD

115V/1ø/60Hz

3/4 HP

**BRONZE CONSTRUCTION** 

SELECTION BASED ON TACO IL133

## HYDRONIC SNOW MELT NOTES

SCALE: NOT TO SCALE

Garrett College STEM Addition & Renovation

REF - M-7.4 - MECHANICAL DETAILS

DATE 02/17/17

ADD M-2.2


SCALE: NONE

11720 Beltsville Drive

Suite 600 Calverton, MD 20705

www.grimmandparker.com



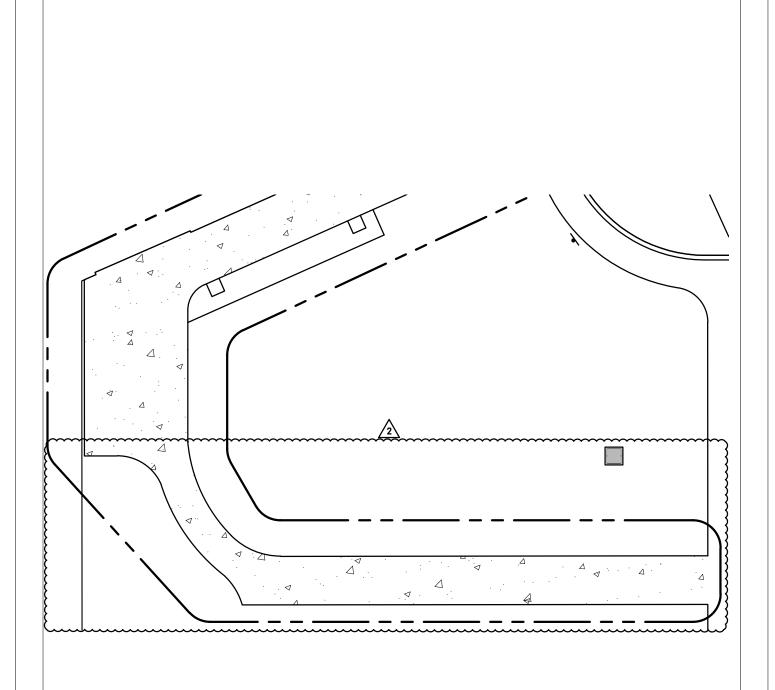

# HYDRONIC HEAT SNOW MELTING PART PLAN

SCALE: NOT TO SCALE

Garrett College STEM Addition & Renovation REF - M-7.4 - MECHANICAL DETAILS

SCALE: NONE

DATE 02/17/17

ADD M-2.3



11720 Beltsville Drive Suite 600 Calverton, MD 20705

www.grimmandparker.com